

**Surveyors Certification**

KENNETH L. FOSTER, P.L.S. Certify that this plot was drawn by me from an actual survey made under my supervision (description recorded in Deed Book SHOWN Page HEREON) that the ratio of precision as calculated exceeds 1:10,000 feet; that this plot was prepared in accordance with G. S. 47-30 as amended. Witness my original signature, license number and seal.

Signature: *Kenneth L. Foster* License Number: 2552  
 This the 2ND Day of NOV 20 04  
 DAVIDSON COUNTY-NORTH CAROLINA

**Surveyors Certification for Subdivision**

KENNETH L. FOSTER Registered Land Surveyor, Number L-2552 certify to one or more of the following as indicated by an X:

X A. That the plot is of a survey that creates a subdivision of land within the area of a county or municipality that has an ordinance that regulates parcels of land;  
 B. That the plot is of a survey that is located in such portion of a county or municipality that is unregulated as to an ordinance that regulates parcels of land;  
 C. That this plot is of a survey of an existing parcel or parcels of land;  
 D. That this plot is of a survey of another category, such as the recombination of existing parcels, a court ordered survey or other exception to the definition of a subdivision;  
 E. That the information available to this surveyor is such that I am unable to make a determination to the best of my professional ability as to provisions contained in A. through D. above.

Signature: *Kenneth L. Foster* License Number: L-2552  
 DAVIDSON COUNTY-NORTH CAROLINA



**Review Officer  
Final Subdivision Plat Approval**

SCOTT LEONAM  
 Review Officer of Davidson County, certify that the map or plat to which this certification is affixed meets all statutory requirements for recording.

APPROVED: *Scott Leonam*  
 This the 3rd Day of NOV 20 04  
 DAVIDSON COUNTY, NORTH CAROLINA

**Davidson County Register of Deeds  
Plat Registration**

FILED FOR REGISTRATION AT \_\_\_\_\_ O'CLOCK \_\_\_\_\_ M  
 This the \_\_\_\_\_ Day of \_\_\_\_\_ 20 \_\_\_\_\_  
 and recorded in Plat Book \_\_\_\_\_ Page \_\_\_\_\_  
 FILING FEE PAID: \_\_\_\_\_  
 BY: \_\_\_\_\_, Register of Deeds  
 Assistant / Deputy  
 DAVIDSON COUNTY, NORTH CAROLINA

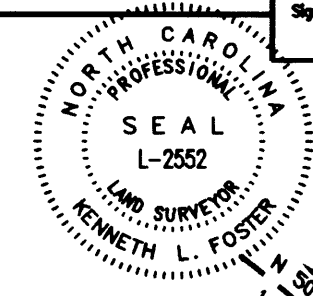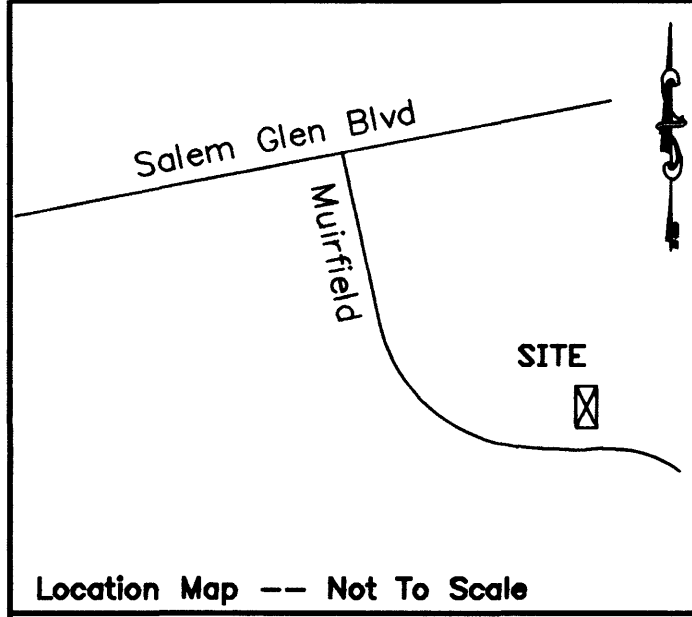

THE UNDERSIGNED HEREBY ACKNOWLEDGE THAT I AM ( WE ARE ) THE OWNERS OF THE PROPERTY SHOWN AND DESCRIBED HEREON AND THAT I ( WE ) HEREBY ADOPT THIS PLAN AND SUBDIVISION WITH MY ( OUR ) FREE CONSENT AND HEREBY DEDICATE TO PUBLIC USE AS ROADS, STREETS AND EASEMENTS FOREVER ALL AREAS SO SHOWN OR INDICATED ON SAID PLAT.

OWNERS SIGNATURE \_\_\_\_\_  
 DATE \_\_\_\_\_

I HEREBY CERTIFY THAT THE SUBDIVISION PLAT SHOWN HEREON HAS BEEN FOUND TO COMPLY WITH THE SUBDIVISION REGULATIONS FOR DAVIDSON COUNTY, NORTH CAROLINA, AND THAT SUCH PLAT HAS BEEN APPROVED ACCORDING TO THE PROCEDURES FOR APPROVAL OF MINOR SUBDIVISIONS.

*Ronald W. Callicutt III*  
 SUBDIVISION ADMINISTRATOR / CHAIRMAN PLANNING BOARD  
 11-3-04  
 DATE

ANY DEVELOPMENT OR CONSTRUCTION ON THE LOTS SHOWN ON THIS PLAT MUST MEET ALL THE BUILDING AND DEVELOPMENT REGULATIONS OF THE APPROPRIATE GOVERNMENT AGENCY.

*Ronald W. Callicutt III*  
 SUBDIVISION ADMINISTRATOR / CHAIRMAN PLANNING BOARD  
 11-3-04  
 DATE

FILED  
 DAVIDSON COUNTY NC  
 11/03/2004 12:49 PM  
 RONALD W. CALLICUTT  
 Register Of Deeds

LOTS 5 - 6 and 27 - 28 RECORDED IN PLAT BOOK 33 PAGE 85  
 LOTS 3-4 and 9-10 RECORDED IN PLAT BOOK 39 PAGE 100  
 LOTS 7-8 RECORDED IN PLAT BOOK 41 PAGE 49

LINE	DIRECTION	DISTANCE
L-1	N 12°46'17" E	26.10'

CURVE	RADIUS	LENGTH	CHORD	BEARING
C-1	585.00'	81.96'	81.89'	N 16°47'07" E
C-2	35.00'	6.38'	6.38'	N 26°01'29" E
C-3	275.00'	18.04'	18.04'	S 75°20'57" E

AS-BUILT PLAT FOR: LOTS 13 & 14,  
 LOTS 15 & 16 and LOTS 37 & 38

**Shugart Enterprises, LLC**  
 Muirfield Lane and Turnbuckle Court, Clemmons, NC

SEE Plat Book 33 PAGE 85 ( COBBLESTONE VILLAGE )

Being:  
 TAX LOT 2B HAMPTON TOWNSHIP MAP 3  
 DAVIDSON COUNTY TAX MAPS

HAMPTON TOWNSHIP / DAVIDSON COUNTY, N.C.

DATE: AUGUST 15, 2003 SCALE: 1" = 50'  
 TOTAL ACRES BY DMD = N/A

**KENNETH L. FOSTER & ASSOCIATES, P.A.**  
 PROFESSIONAL LAND SURVEYORS - PLANNERS  
 2200 SILAS CREEK PARKWAY SUITE 1-B  
 WINSTON-SALEM, NORTH CAROLINA 27103  
 TELEPHONE: 336 / 723-8850

SHEET 1 OF 1 JOB NO: 2810-04C

